




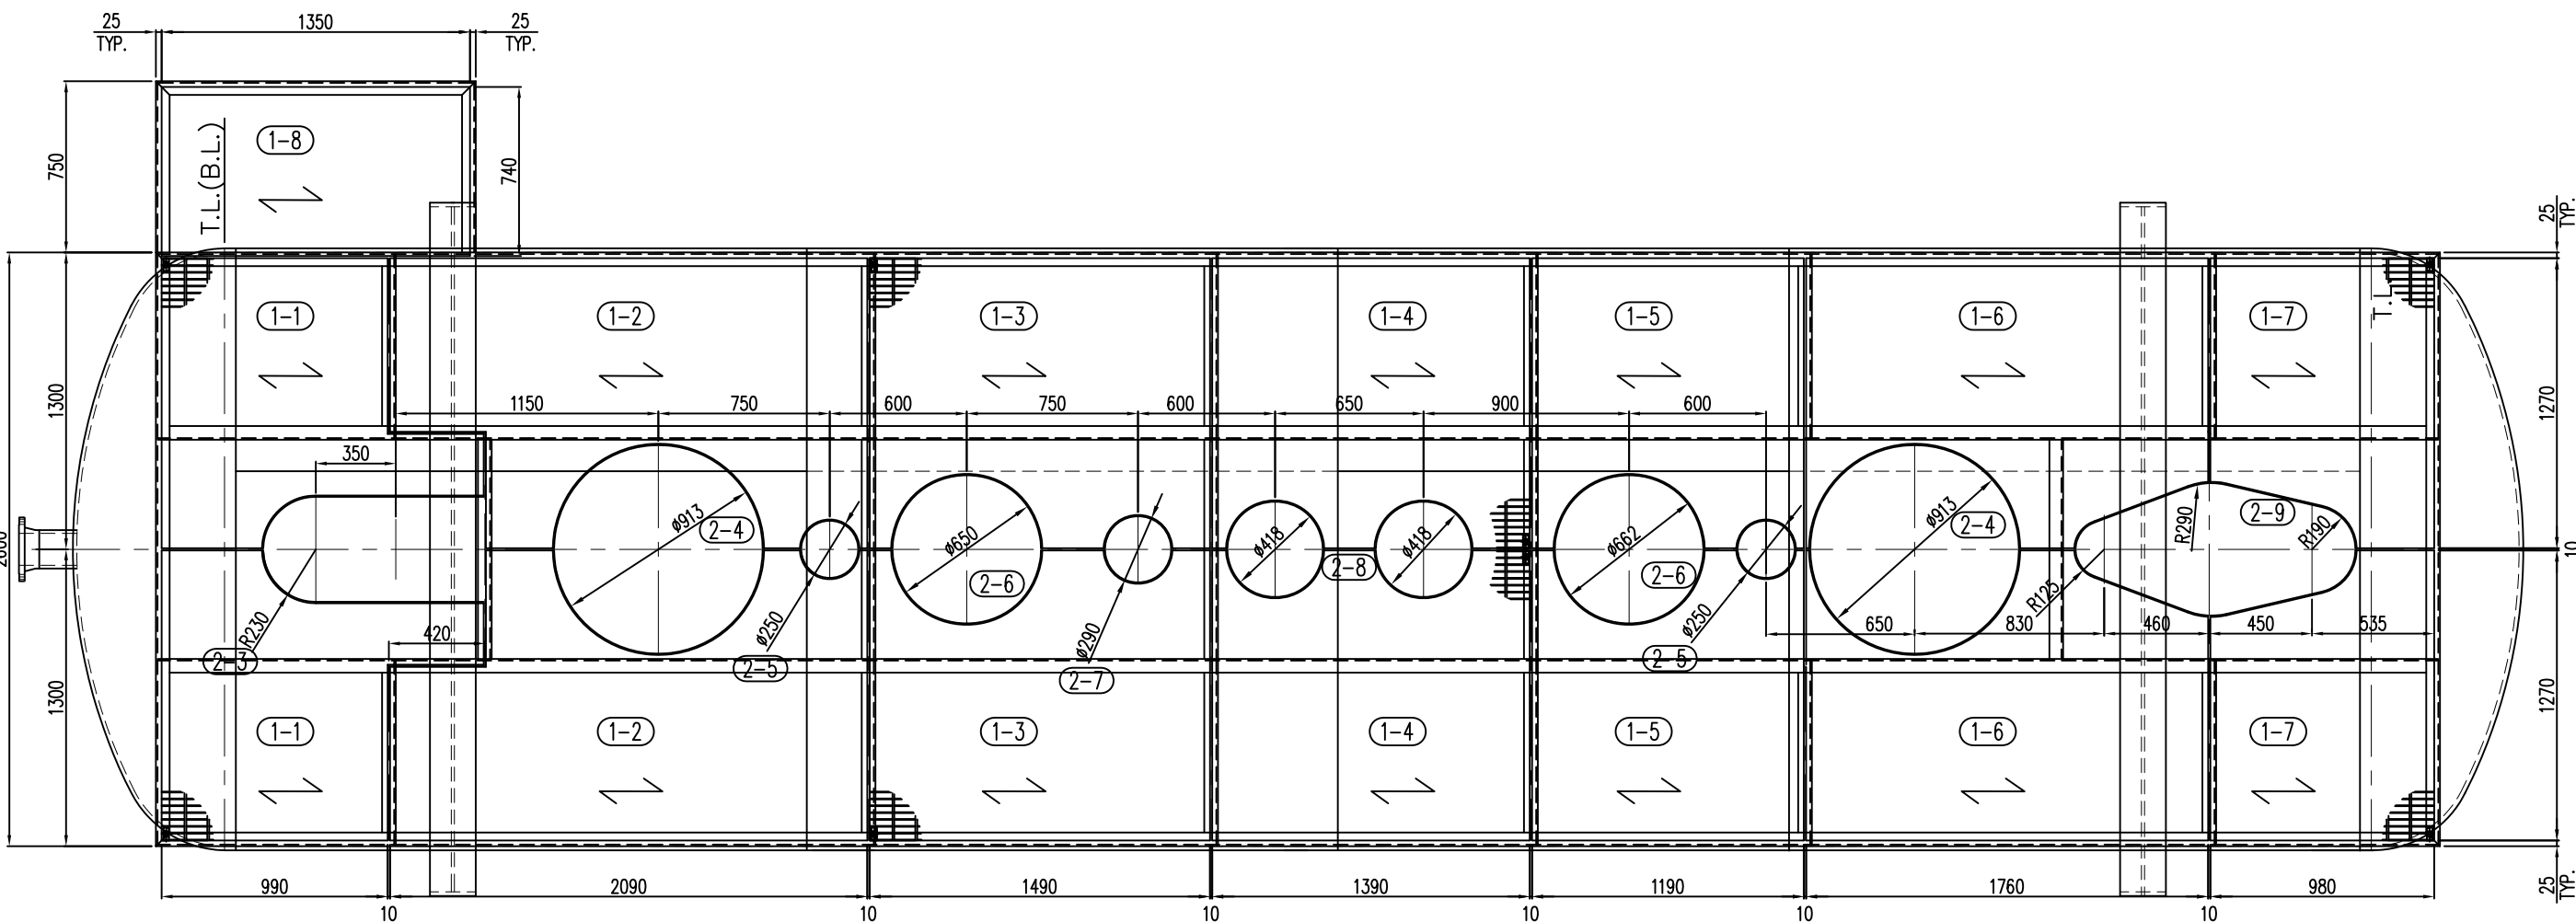


TOP VIEW
T.O.P. EL.+0.00

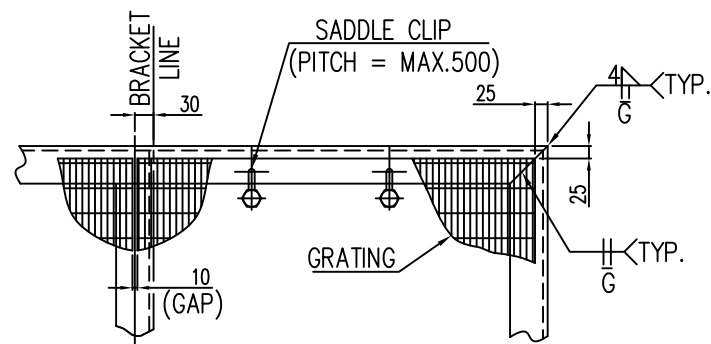


GRATING SETTING

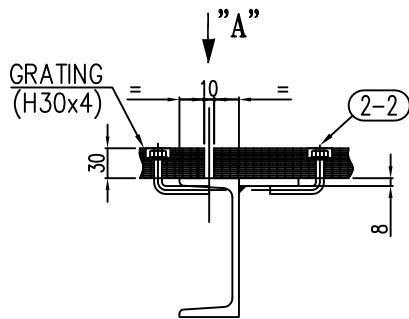

SADDLE CLIP

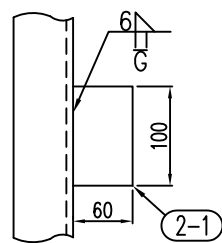


VIEW "A"

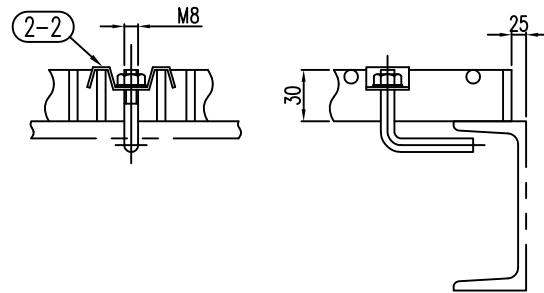


SADDLE CLIP DETAIL


(MIN. 4 FASTENERS REQUIRED PER ONE (1) PANEL)

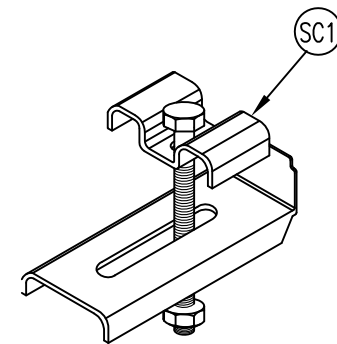


NORMAL CLIP

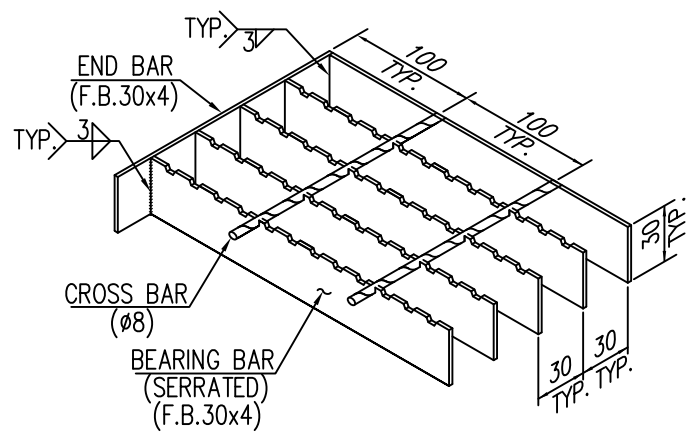


GRATING

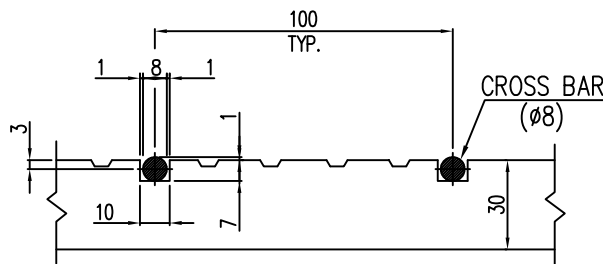

TYP.GRATING DETAIL

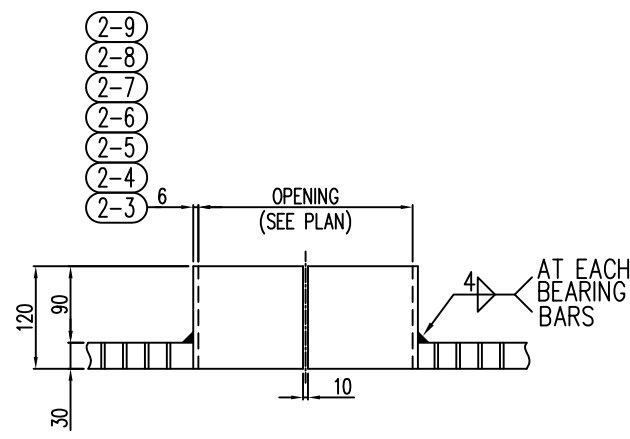

GRATING OPENING DETAIL

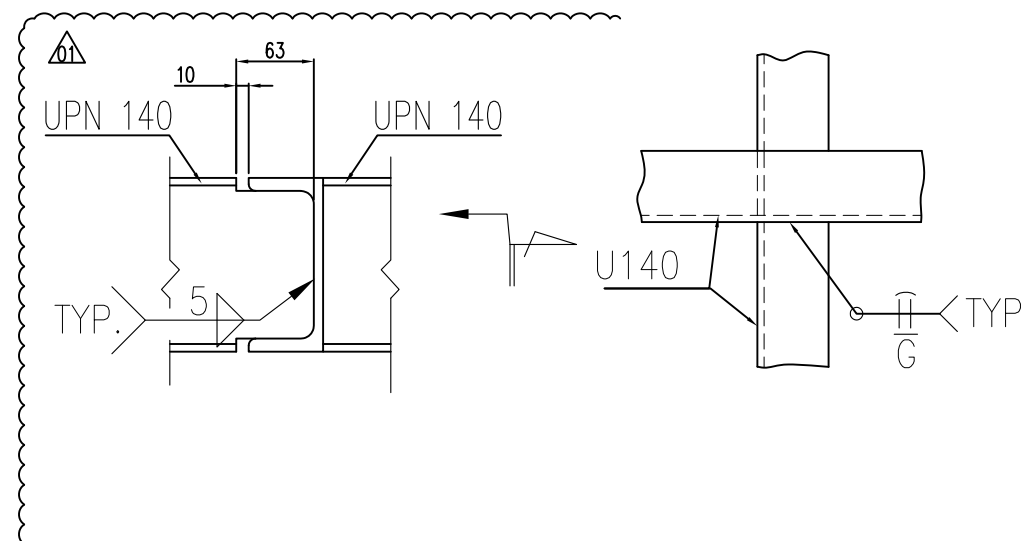

FRAME CONNECTION DETAIL

BILL OF MATERIALS

NO.	PARTICULARS	RQD	WEIGHT (Kg)		MATERIAL	REMARK
		MAIN	UNIT	TOTAL		
1-1	GRATING 1270 X 990	2	44	88	ST 37	
1-2	GRATING 1270 X 2090	2	93	186	ST 37	
1-3	GRATING 1270 X 1490	2	66	132	ST 37	
1-4	GRATING 1270 X 1390	2	62	124	ST 37	
1-5	GRATING 1270 X 1190	2	53	106	ST 37	
1-6	GRATING 1270 X 1760	2	73.5	147	ST 37	
1-7	GRATING 1270 X 980	2	43.5	87	ST 37	
1-8	GRATING 740 X 1350	1	35	35	ST 37	
2-1	PL 8 X 60 X 100	28	0.3	7.2	ST 37	SUPPORT PLATE
2-2	HEX. B/N/W M8 . L=90	72	0.03	2.1	Gr.8.8	SADDLE CLIP
2-3	SLEEVE PL 6 X 120 X 1096	2	6	12	ST 37	
2-4	SLEEVE PL 6 X 120 X 1434	4	8	32	ST 37	
2-5	SLEEVE PL 6 X 120 X 392	4	2.2	8.8	ST 37	
2-6	SLEEVE PL 6 X 120 X 1020	4	6	24	ST 37	
2-7	SLEEVE PL 6 X 120 X 455	2	2.5	5	ST 37	
2-8	SLEEVE PL 6 X 120 X 656	4	3.7	14.8	ST 37	
2-9	SLEEVE PL 6 X 120 X 1445	2	8	16	ST 37	

WEIGHT PER 1 SET : 1026.9 Kg
NUMBER OF SETS : 1
TOTAL WEIGHT : 1026.9 Kg

AS BUILT

01	05.Oct.2019	Issued for Approval	s.shahbazi	M.pilevar	M.jafari	--
00	19.May.2019	Issued for Approval	s.shahbazi	M.pilevar	M.jafari	--
Rev.	Date	Status	Prep.	Chk.	App.	R.S.

MANGEMENT CONTRACTOR:	CLIENT:
	
CONTRACTOR:	
	

PROJECT TITLE:
SOUTH AZADEGAN OIL FIELD DEVELOPMENT PROJECT
PHASE1-MANIFOLD STATIONS & TRUNK LINES (NORTH SIDE)

FACILITIES: SURFACE PRODUCTION FACILITIES

DRAWING TITLE: LADDER & PLATFORM DRAWING (GRATING)
FOR (V-30337100) CLOSED DRAIN DRUM

SCALE		SIZE		CLASS		
1/30		A2		A		
NO CONSTRUCTION PERMITTED UNLESS DRAWING APPROVED						
DOCUMENT NUMBER : SA01-PV-FSFXX-ME-DWVD-2007-01				VD-V090-0120-007		SHEET
PROJECT/SUB PRO.	SCOPE	DISCIPLINE CODE	DOCUMENT CODE	SEQUENCE No.	REVISION	
SA01-PV	FSFXX	ME	DWVD	2007	01	
						4/4

THE ORIGINAL AND ALL COPIES OF THIS DRAWING TOGETHER WITH THE COPYRIGHT THEREIN ARE THE SOLE PROPERTY OF PEDEC.

