

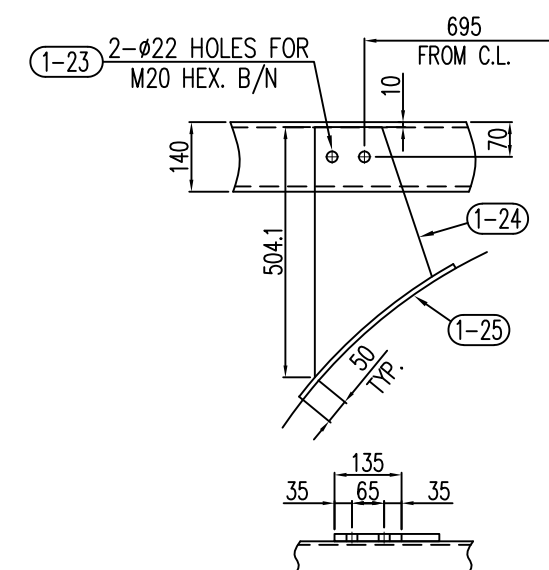
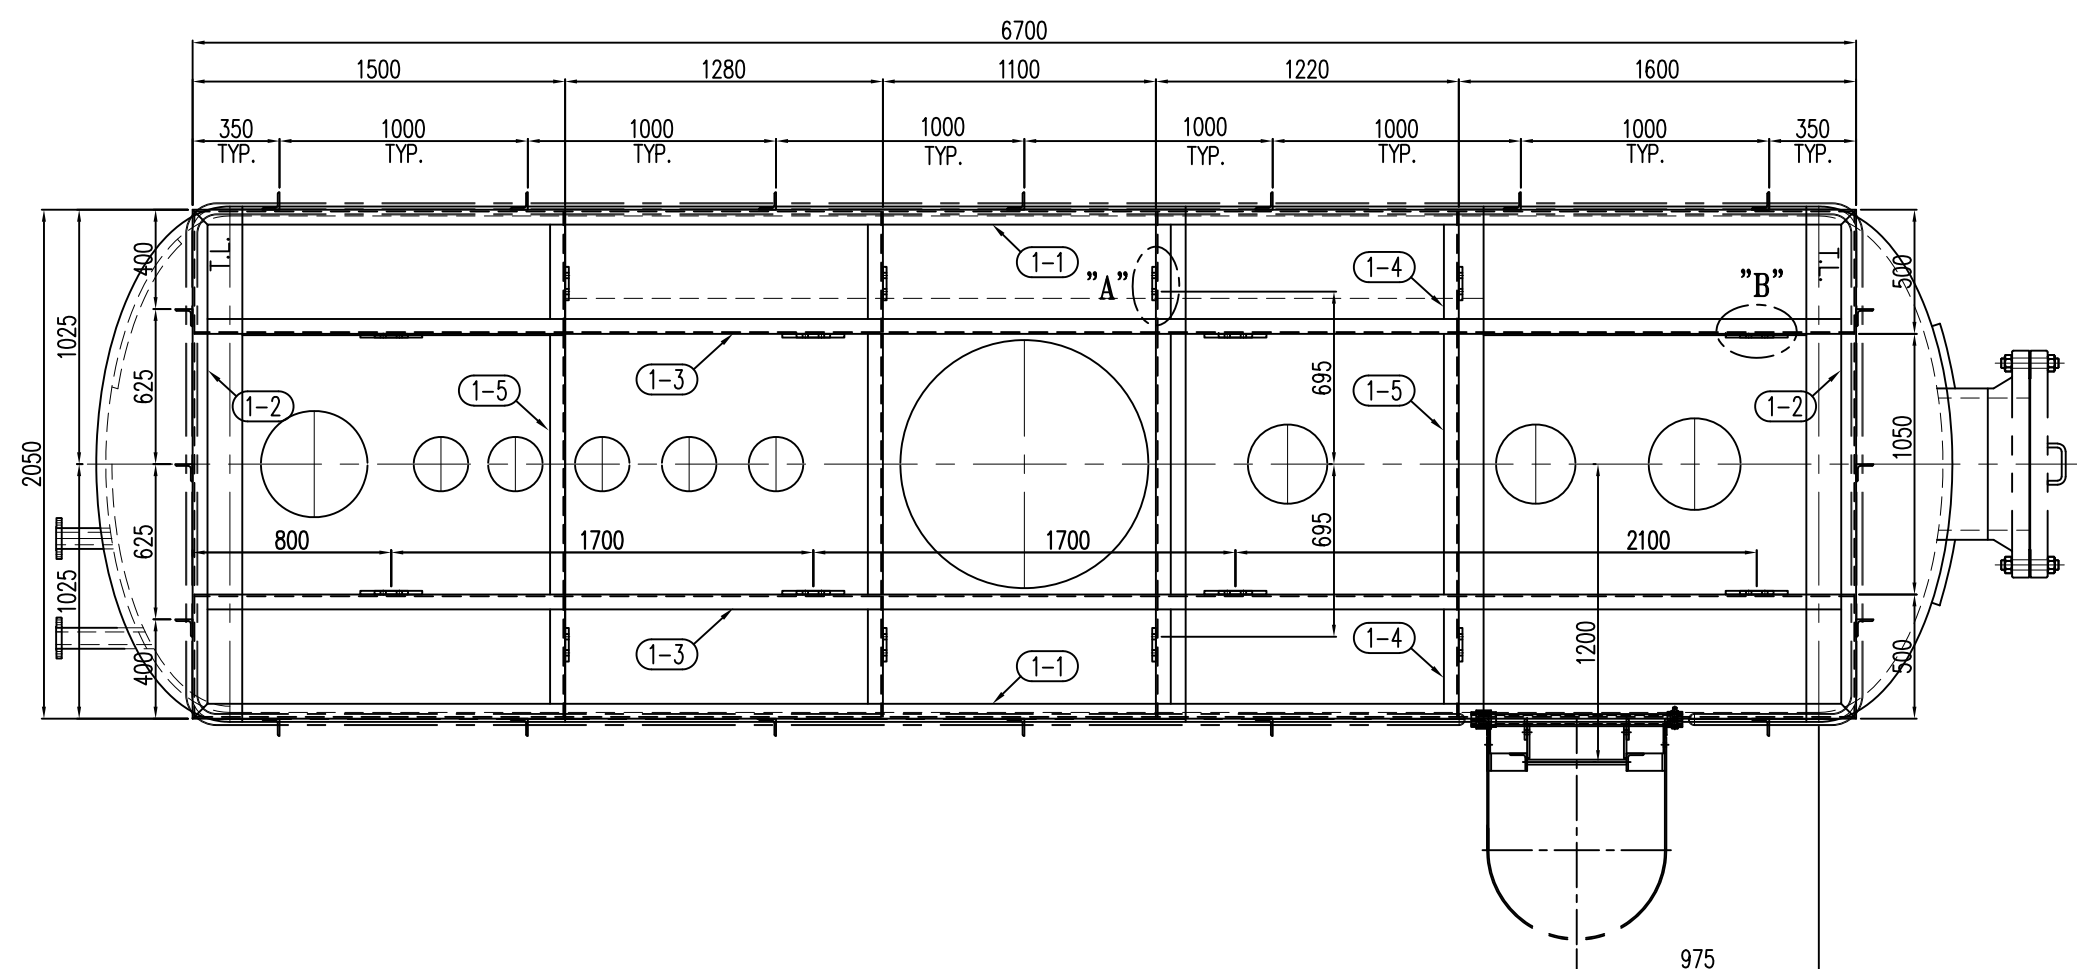
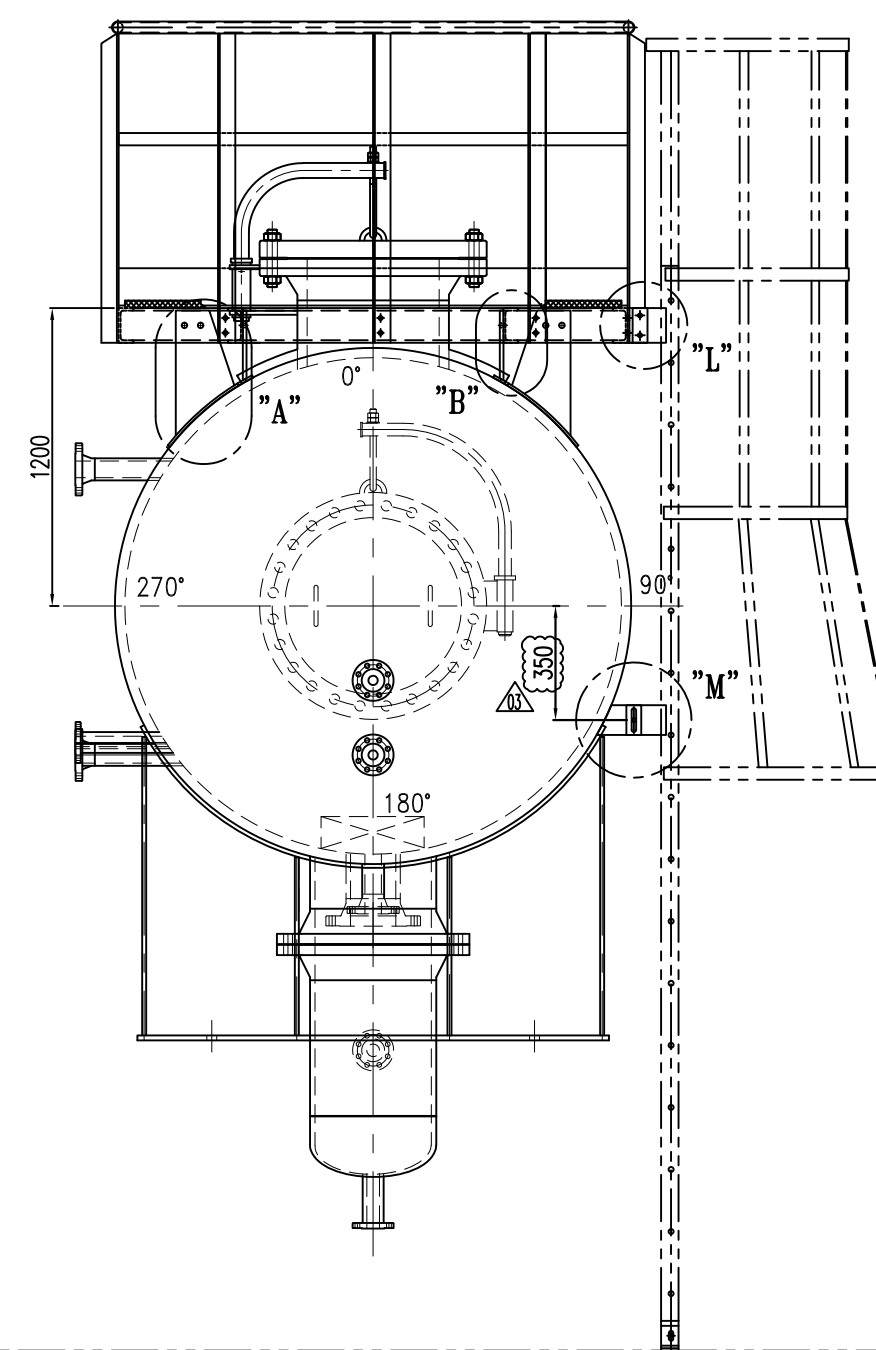


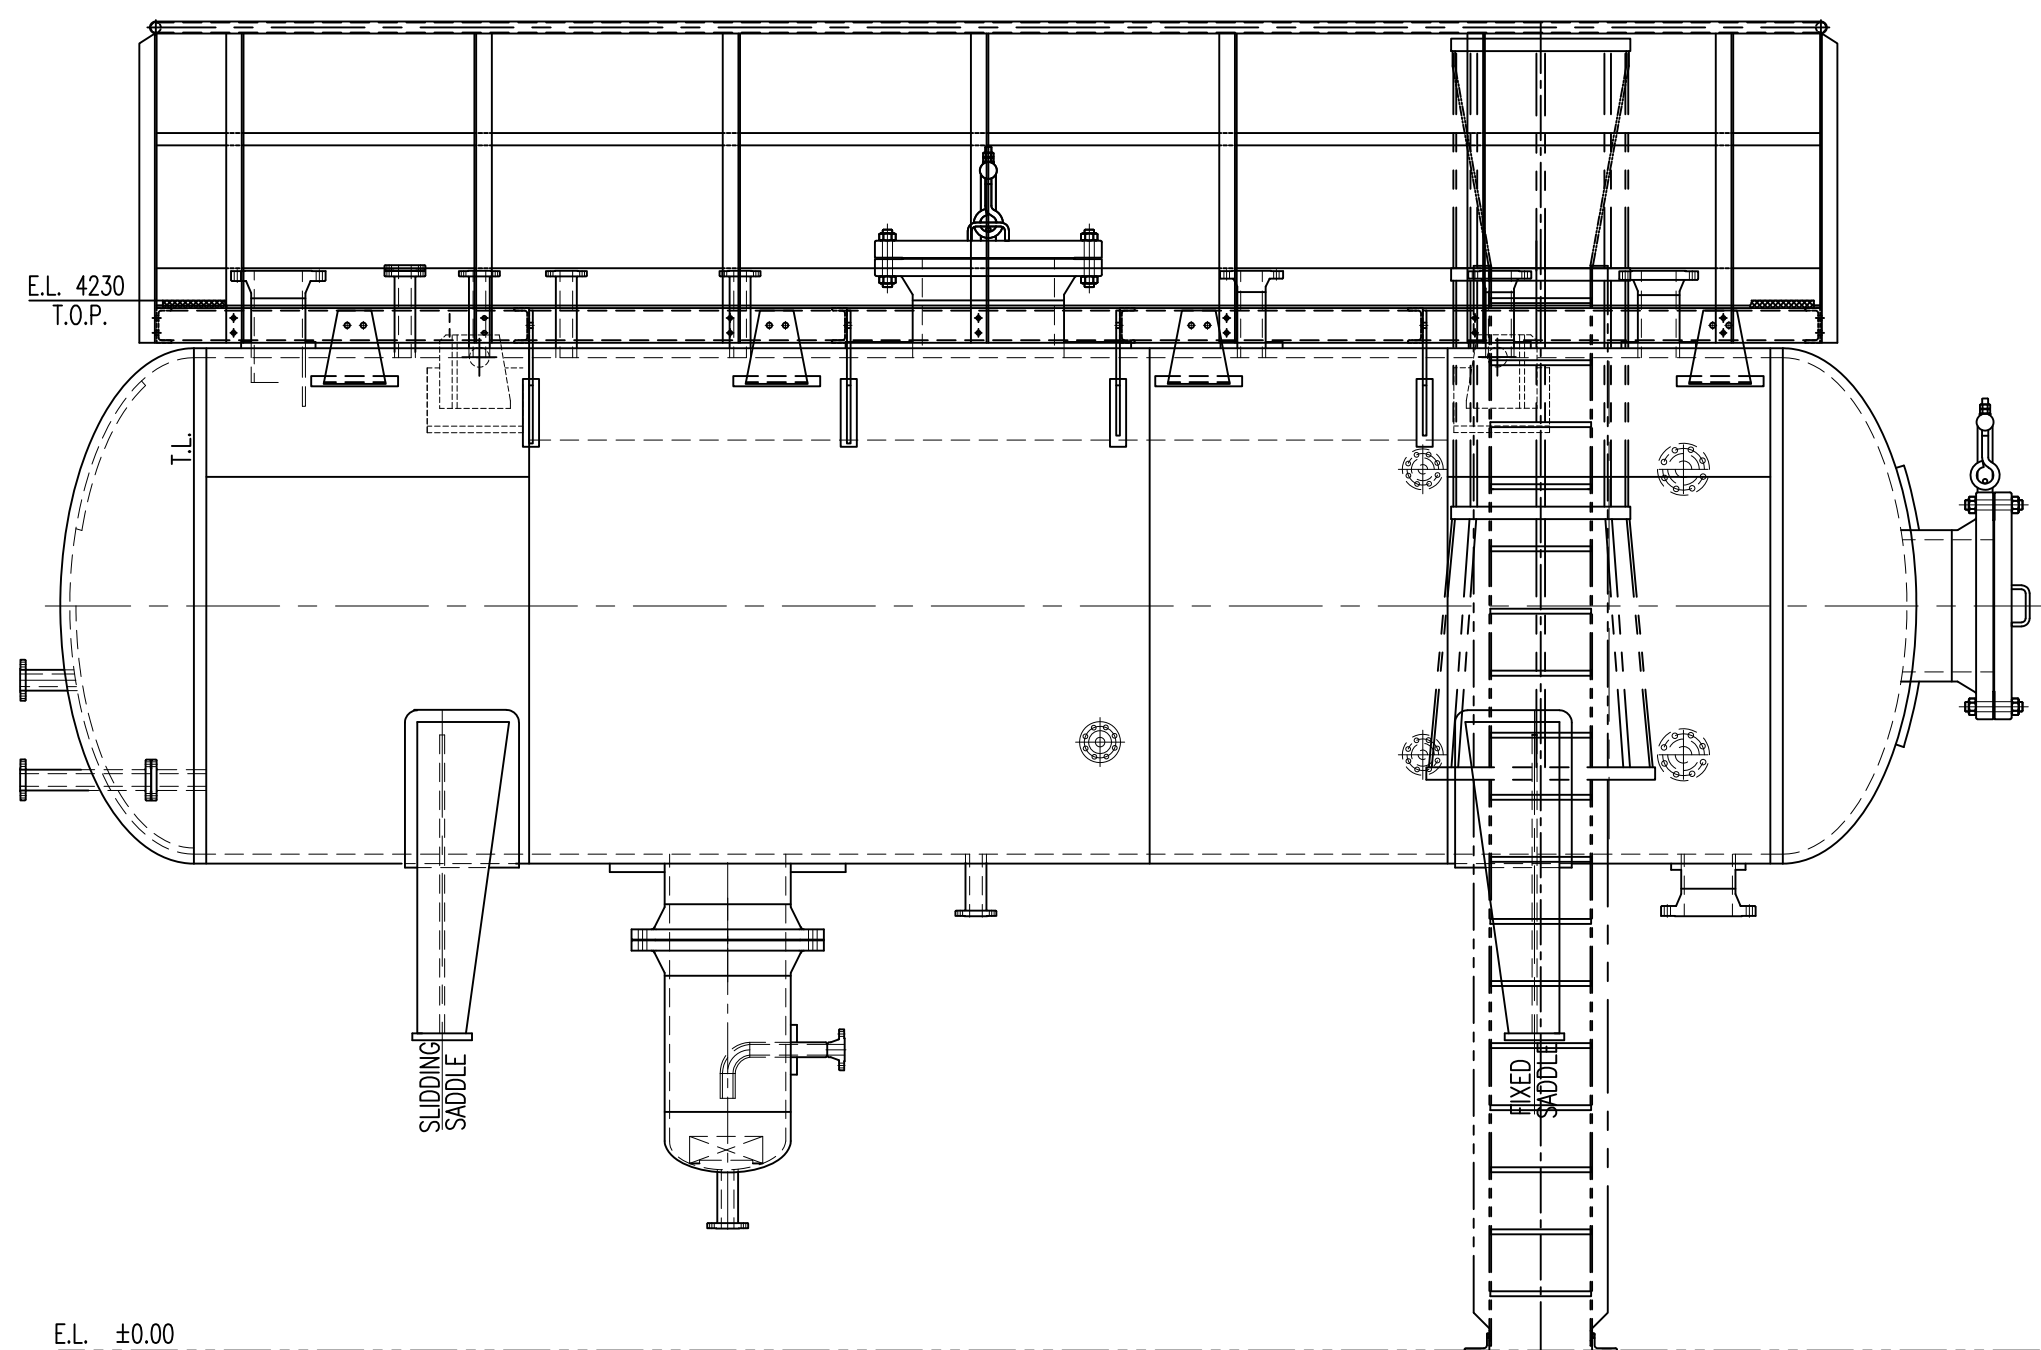

DETAIL "A"

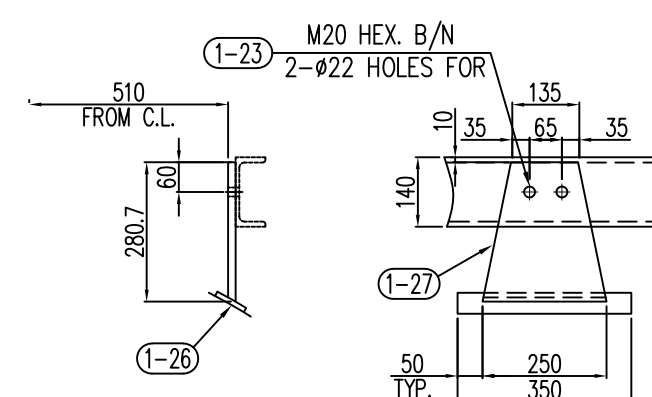

DETAIL "B"

BILL OF MATERIALS							
NO.	PARTICULARS	RQD		WEIGHT (Kg)		MATERIAL	REMARK
		MAIN	SPLA	UNIT	TOTAL		
1-1	UPN 140 X L=6700	2		115	230	ST 37	
1-2	UPN 140 X L=2050	2		35	70	ST 37	
1-3	UPN 140 X L=6686	2		114.3	228.6	ST 37	
1-4	UPN 140 X L=486	8		8.2	65.6	ST 37	
1-5	UPN 140 X L=1050	4		18	72	ST 37	
1-6	F.B. 150 X 6 X L=16552	1		117	117	ST 37	
1-7	F.B. 50 X 8 X L=16552	1		52	52	ST 37	
1-8	PIPE 1,1/2" ,SCH.40 X L=16456	1		65.7	65.7	SA 53	
1-8a	CAP 1,1/2" ,SCH.40	2		0.05	0.1	SA 420-WPL6	
1-9	L 70 X 70 X 7 X L= 1295	2		9.5	19	ST 37	
1-10	L 70 X 70 X 7 X L=1246	19		9	171	ST 37	
1-11	PL. 6 X 110 X110	2		0.5	1	ST 37	
1-12	PL. 5 X 60 X 60	2		0.1	0.2	ST 37	
1-13	PL. 10 X 15 X 30	1		0.03	0.03	ST 37	
1-14	PIPE 1/2" ,SCH.STD X L=50	1		0.06	0.06	SA 53	
1-15	PL. 5 X 60 X 62	1		0.1	0.1	ST 37	
1-15a	CLEVIS PINØ15 ,L=80	1		0.01	0.01	ST 37	ISO 2341-B-16X80X4-ST
1-15b	SPLIT PIN Ø4 ,L=25	1		0.1	0.1	FA 436	DIN 94-4X25-ST
1-15c	WASHER I.D. 18 X 0.028 X THK.=4	2		0.03	0.06	ST 37	ISO 8738-18-ST
1-16	PL. 5 X 60 X 60	3		0.06	0.18	ST 37	
1-17	PL. 10 X 30 X 40	1		0.1	0.1	ST 37	
1-18	PIPE 2" ,SCH.80 X L=100	1		7.3	7.3	PLASTIC	
1-19	PIPE 1,1/4" ,SCH.40 X L=850	1		28.3	28.3	SA 53	
1-20	PL. 5 X 60 X 74	1		0.2	0.2	ST 37	
1-21	HEX. BOLT & NUT/W M16, L=40	44		--	--	A193-Gr.B7M/194-Gr.2HM	
1-22	PL 10 X 80 X 140	2		0.8	1.6	ST 37	
1-23	HEX B/N M20 x 55L	32		0.25	8	A193-Gr.B7M/194-Gr.2HM	
1-24	PL. 15 X 235 X 504	8		13.9	111.2	ST 37	
1-25	PL. 10 X 65 X 411	8		2	16	SA516-70	
1-26	PL. 10 X 65 X 350	8		1.8	14.4	SA516-70	
1-27	PL. 15 X 250 X 280.7	8		8.2	65.6	ST 37	
1-28	PL. 10 X 120 X 179.3	2		1.7	3.4	ST 37	

WEIGHT PER 1 SET :	1348.8	Kg
NUMBER OF SETS :	1	
TOTAL WEIGHT :	1348.8	Kg

AS BUILT

03	18.Jun.2021	AS BUILT	s.shahbazi	M.pilevar	M.jafari	--
02	05.May.2019	Issued for Approval	s.shahbazi	M.pilevar	M.jafari	--
01	10.Mar.2019	Issued for Approval	s.shahbazi	M.pilevar	M.jafari	--
00	17.Feb.2019	Issued for Approval	s.shahbazi	M.pilevar	M.jafari	--
Rev.	Date	Status	Prep.	Chk.	App.	R.S.

MANAGEMENT CONTRACTOR:  Petropars Ltd.	CLIENT:  PEDEC
CONTRACTOR:  AZADSHAH ENCO	

PROJECT TITLE:
SOUTH AZADEGAN OIL FIELD DEVELOPMENT PROJECT
PHASE1-MANIFOLD STATIONS & TRUNK LINES (NORTH SIDE)

FACILITIES:	SURFACE PRODUCTION FACILITIES
-------------	-------------------------------

DRAWING TITLE: LADDER & PLATFORM DRAWING
FOR TEST SEPARATOR (SE-30615100)

SCALE	SIZE	CLASS
1/30	A2	A

NO CONSTRUCTION PERMITTED UNLESS DRAWING APPROVED

DOCUMENT NUMBER :SA01-PV-FSFX-ME-DWVD-2507-03					VD-V090-0125-007		SHEET
PROJECT/SUB PRO.	SCOPE	DISCIPLINE CODE	DOCUMENT CODE	SEQUENCE No.	REVISION		
SA01-PV	FSFX	ME	DWVD	2507	03	1/4	

THE ORIGINAL AND ALL COPIES OF THIS DRAWING TOGETHER WITH THE COPYRIGHT THEREIN ARE THE SOLE PROPERTY OF PEDEC.

DETAIL OF SAFETY GATE

DETAIL OF HANDRAIL

DETAIL OF CLEVIS PIN/W

DETAIL "D"

VIEW "C"

DETAIL "I"

VIEW "J"

DETAIL "F"

VIEW "E"

DETAIL "G"

VIEW "H"

DETAIL "L"

DETAIL "M"

DETAIL "K"

BILL OF MATERIALS								
NO.	PARTICULARS	RQD	WEIGHT (Kg)		MATERIAL	REMARK		
		MAIN	SPL	UNIT			TOTAL	
AS BUILT								
03	18.Jun.2021	AS BUILT			s.shahbazi	M.pilevar	M.jafari	--
02	05.May.2019	Issued for Approval			s.shahbazi	M.pilevar	M.jafari	--
01	10.Mar.2019	Issued for Approval			s.shahbazi	M.pilevar	M.jafari	--
00	17.Feb.2019	Issued for Approval			s.shahbazi	M.pilevar	M.jafari	--
Rev.	Date	Status			Prep.	Chk.	App.	R.S.
MANAGEMENT CONTRACTOR:				CLIENT:				
CONTRACTOR:								
PROJECT TITLE:								
SOUTH AZADEGAN OIL FIELD DEVELOPMENT PROJECT								
PHASE1–MANIFOLD STATIONS & TRUNK LINES (NORTH SIDE)								
FACILITIES: SURFACE PRODUCTION FACILITIES								
DRAWING TITLE:								
LADDER & PLATFORM DRAWING								
FOR TEST SEPARATOR (SE-30615100)								
SCALE		SIZE			CLASS			
1/30		A2			A			
NO CONSTRUCTION PERMITTED UNLESS DRAWING APPROVED								
DOCUMENT NUMBER : SA01-PV-FSFX-ME-DWVD-2507-03					VD-V090-0125-007		SHEET	
PROJECT/SUB PRO.	SCOPE	DISCIPLINE CODE	DOCUMENT CODE	SEQUENCE No.	REVISION			
SA01–PV	FSFX	ME	DWVD	2507	03	2/4		