




7										8											
BILL OF MATERIALS																					
NO.	PARTICULARS	RQD		WEIGHT (Kg)		MATERIAL	REMARK														
		MAIN	SPA	UNIT	TOTAL																
16-1	L 70 X 70 X 7 X L= 6850	2		47	94	SA 36	LADDER														
16-2	F.B. 70 X 10 X L= 917	2		5	10	SA 36	LADDER														
17	R.B. Ø20 X L=406	27		0.8	33	SA 36	LADDER														
18-1	F.B. 50 X 6 X L=2550	1		6	6	SA 36	HOOP#1														
18-2	F.B. 50 X 6 X L=1960	3		5	15	SA 36	HOOP#2														
18-3	F.B. 50 X 6 X L=2225	1		5	5	SA 36	HOOP#3														
19-1	PL. 10 X 160 X 140	2		2	4	SA 36	LADDER CON.														
19-2	PL. 10 X 150 X 140	2		2	4	SA 36	LADDER CON.														
19-3	PL. 10 X 110 X 110	2		2	4	SA 36	LADDER CON.														
20-1	F.B. 35 X 6 X L=5395	5		6.7	33.4	SA 36	CAGE														
20-2	F.B. 35 X 6 X L=500	2		1.5	3	SA 36	CAGE														
21	PL. 10 X 160 X 120	2		2	4	SA 36	LADDER CON.														
22	L 100 X 100 X 10 X L= 70	2		1	2	SA 36	SUPPORT CON.														
B5	EXPANSION BOLT & NUT/W M16, L=100	SET		-		SA193 GR.B7M/SA194-GR.2HM															
						WEIGHT PER 1 SET : 217 Kg NUMBER OF SETS : 1 TOTAL WEIGHT : 217 Kg															
NOTES																					
1. UNLESS OTHERWISE NOTED ALL DIMENSIONS ARE IN MILLIMETERS. 2. ALL SURFACES SHALL BE COATED AS PER SPECIFICATION NO: NGWK-0001-ENPI-SPPA-2308. 3. ALL BOLTS & NUTS SHALL BE HOT DIP GALVANIZED. 4. ABBREVIATIONS: H.P.P. = HIGH POINT OF PAVING T.O.P. = TOP OF PLATFORM T.O.S. = TOP OF STRUCTURE T.O.C. = TOP OF CONCRETE T.O.P. = T.O.S.+30 (FOR TOP PLATFORM)																					
پرای ساخت FOR FABRICATION AZARAB IND CO DESIGN & ENG DEPT.																					
03	29-Nov-2023	ISSUED FOR APPROVAL				M.Dusti	M.Pilehvar	M.Jafari													
02	04-Feb-2023	ISSUED FOR APPROVAL				M.Dusti	A.Ghorbani	M.Jafari													
01	25-Sep-2019	ISSUED FOR APPROVAL				F.Alikhani	A.Ghorbani	M.Jafari													
00	20.Mar.2017	ISSUED FOR APPROVAL				NOR.	FS	Morshedi	GRM												
Rev.	Date	Status				Prep.	Chk.	App.	R.S.												
MANGEMENT CONTRACTOR:						CLIENT:															
ENERCHIMI Contractor Ltd						PEDEC															
CONTRACTOR:																					
PEDEC																					
PROJECT TITLE:																					
SOUTH AZADEGAN OIL FIELD DEVELOPMENT PROJECT																					
VESSEL DRUMS PACKAGE																					
FACILITIES:																					
SURFACE PRODUCTION FACILITIES																					
DRAWING TITLE:																					
LADDER & PLATFORM (PLATFORM)																					
FOR (SE-20027100) CLOSED DRAIN DRUM																					
SCALE				SIZE				CLASS													
1/60				A2				A													
NO CONSTRUCTION PERMITTED UNLESS DRAWING APPROVED																					
DOCUMENT NUMBER : SA01-PV-CTEPX-ME-DWVD-0307										VD-V090-0103-07											
PROJECT/SUB PRO.		SCOPE		DISCIPLINE CODE		DOCUMENT CODE		SEQUENCE No.		REVISION		SHEET									
SA01-PV		CTEPX		ME		DWVD		0307		03		3/4									
7										8											

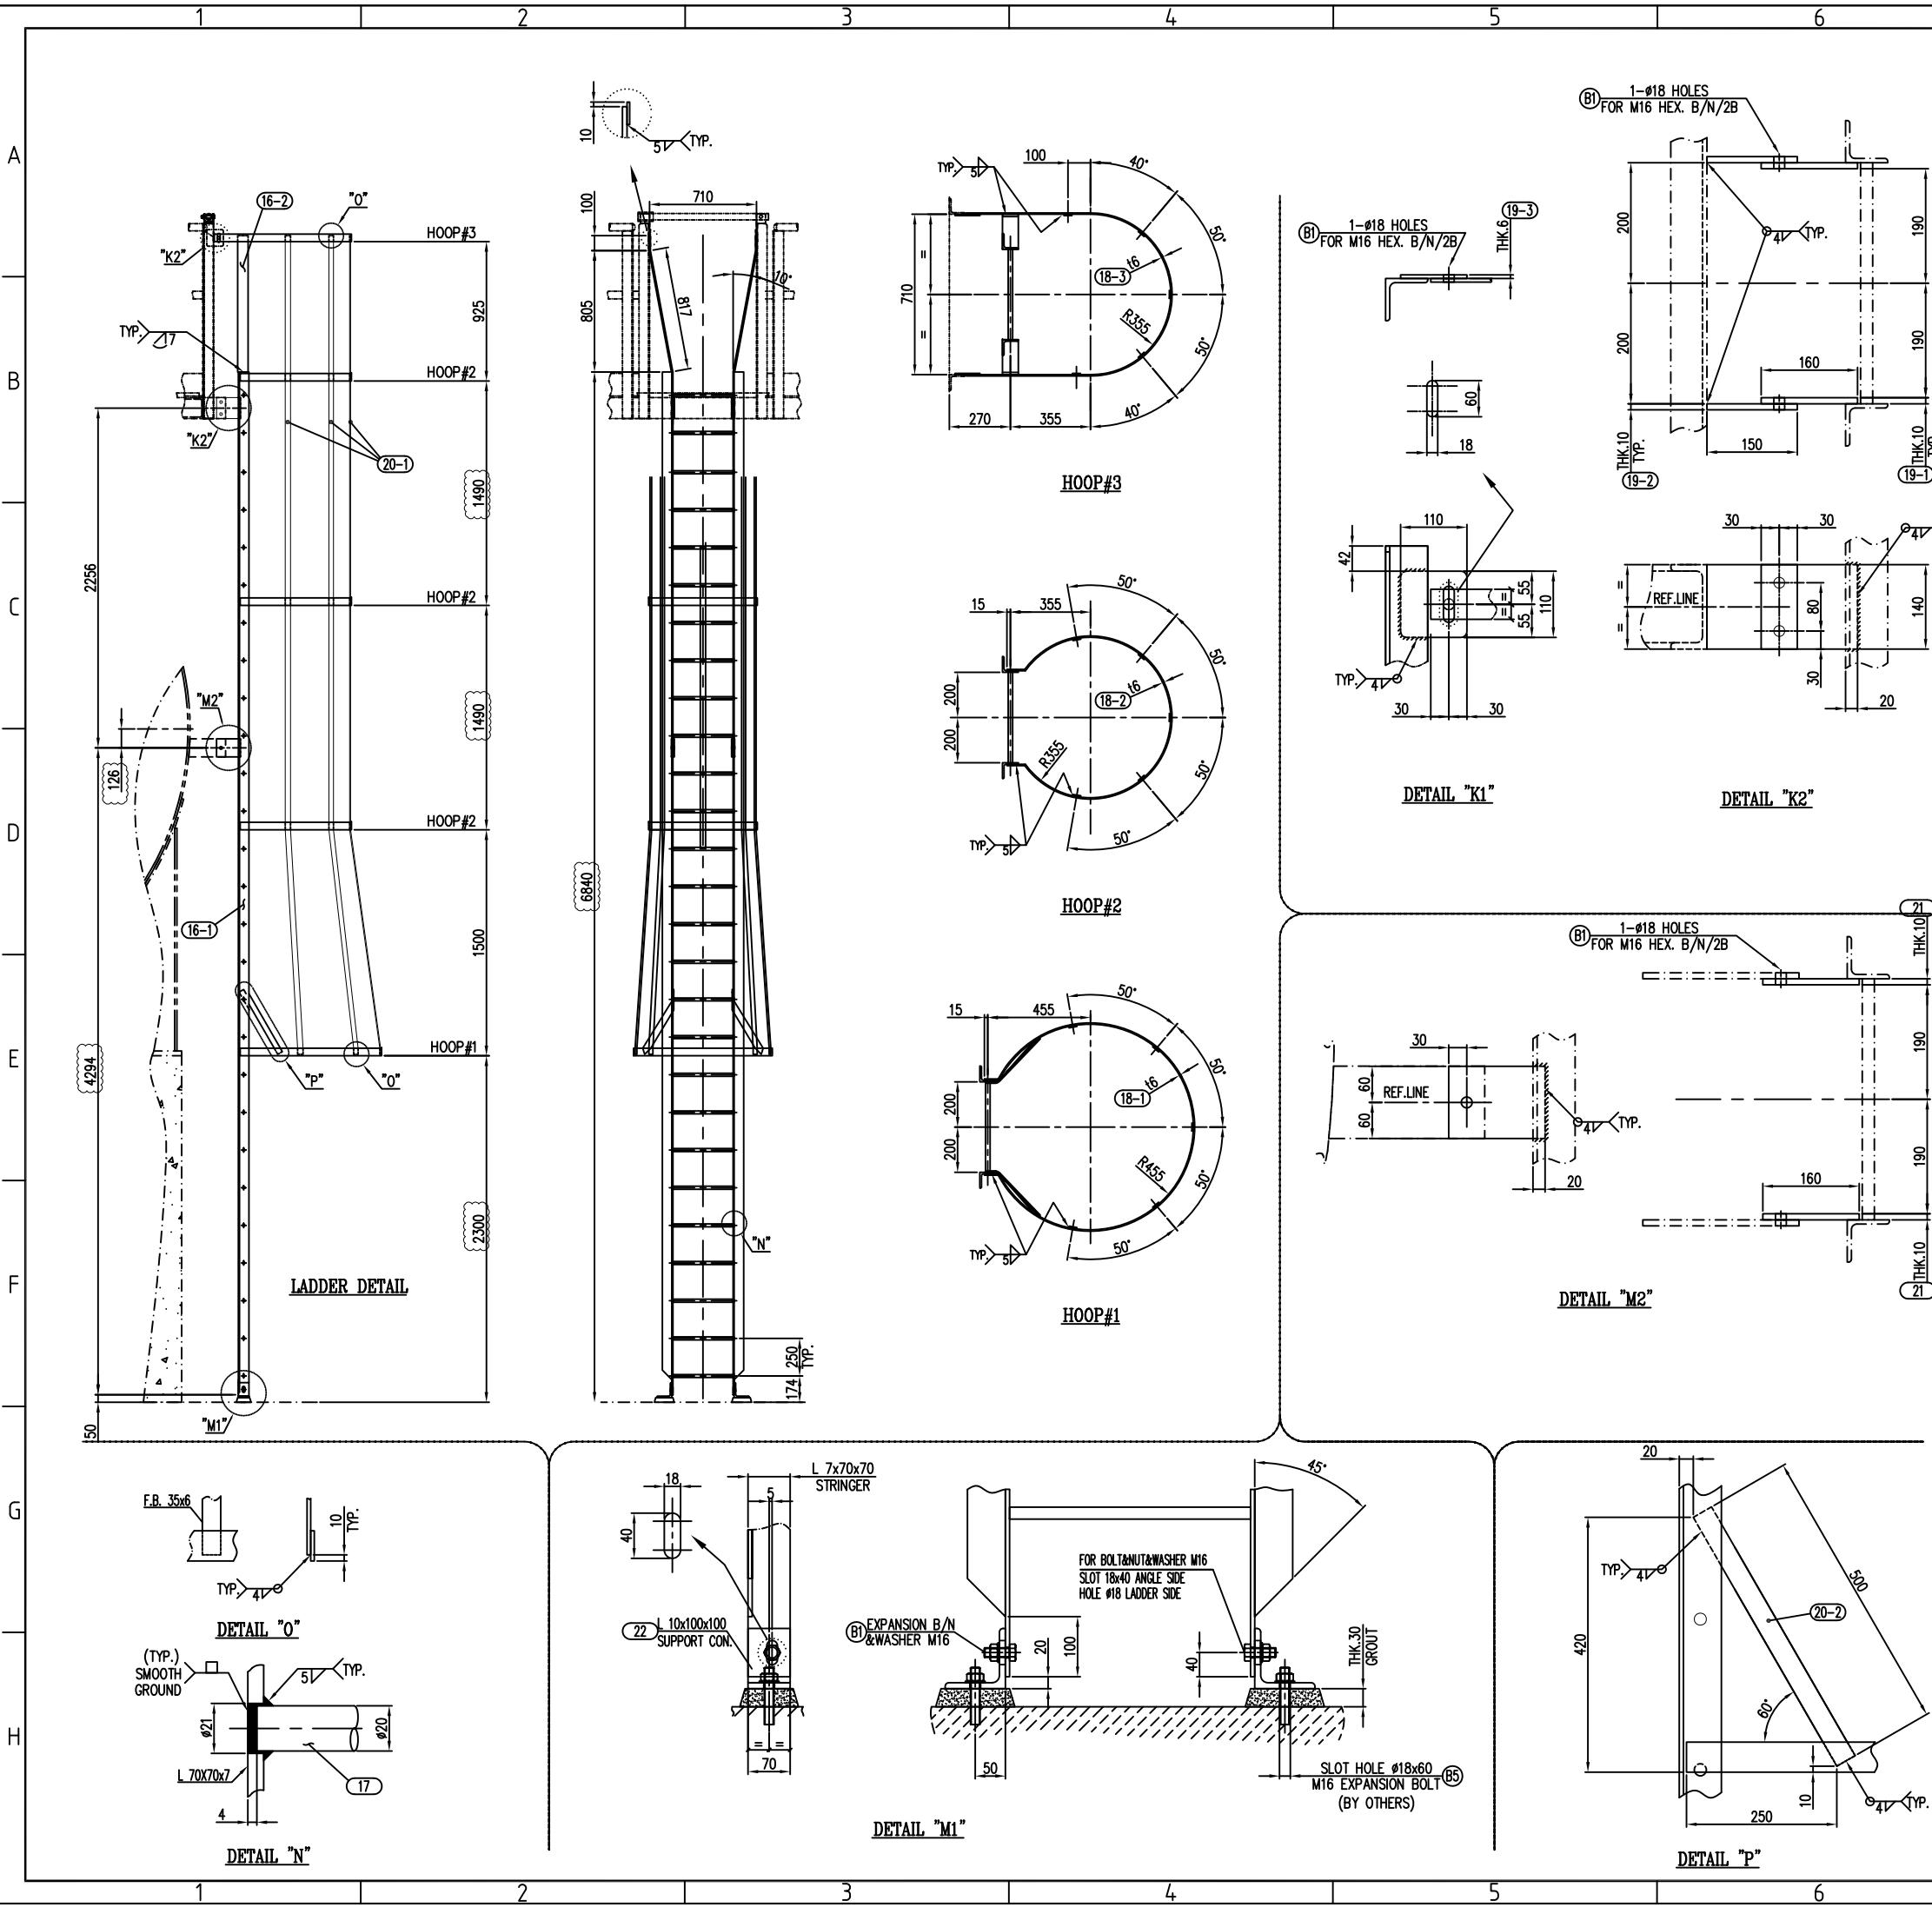